RIVERSIDE COMMUNITY CLINIC

CONSTRUCTION DOCUMENTS - SYNTHETIC SAMPLE SET (FICTIONAL PROJECT, NOT FOR CONSTRUCTION)

SHEET INDEX

SHEET	SHEET TITLE
G-001	COVER SHEET AND SHEET INDEX
A-101	FIRST FLOOR PLAN
A-501	DOOR AND STOREFRONT DETAILS
A-601	DOOR SCHEDULE AND DOOR TYPES
M-101	MECHANICAL FLOOR PLAN
M-601	MECHANICAL EQUIPMENT SCHEDULE
E-601	ELECTRICAL PANEL SCHEDULES

ABBREVIATIONS

AFF ABOVE FINISHED FLOOR
EQ EQUAL
HM HOLLOW METAL
NIC NOT IN CONTRACT
SIM SIMILAR
TYP TYPICAL
WD WOOD
MCA MINIMUM CIRCUIT AMPACITY
V/PH VOLTS / PHASE

GENERAL NOTES

1. ALL DOCUMENTS IN THIS SET ARE SYNTHETIC AND FOR SOFTWARE DEMONSTRATION ONLY.
2. DIMENSIONS GOVERN. DO NOT SCALE DRAWINGS.
3. REFER TO THE PROJECT MANUAL FOR SPECIFICATIONS.

NORTHWIND DESIGN STUDIO

SYNTHETIC SAMPLE - NOT FOR CONSTRUCTION

PROJECT:

RIVERSIDE COMMUNITY CLINIC

PROJECT NO.: 2026-014

REVISIONS

REV	DATE	DESCRIPTION
A	2026-08-14	ISSUED FOR BID

SHEET TITLE:

COVER SHEET AND SHEET INDEX

SCALE:


AS NOTED

SHEET NO.

G-001

GENERAL NOTES:

1. DIMENSIONS ARE TO GRID LINES UNLESS NOTED OTHERWISE. DO NOT SCALE DRAWINGS.
2. SEE A-601 FOR DOOR SCHEDULE AND DOOR TYPES. DOOR TAGS SHOW DOOR NUMBER.

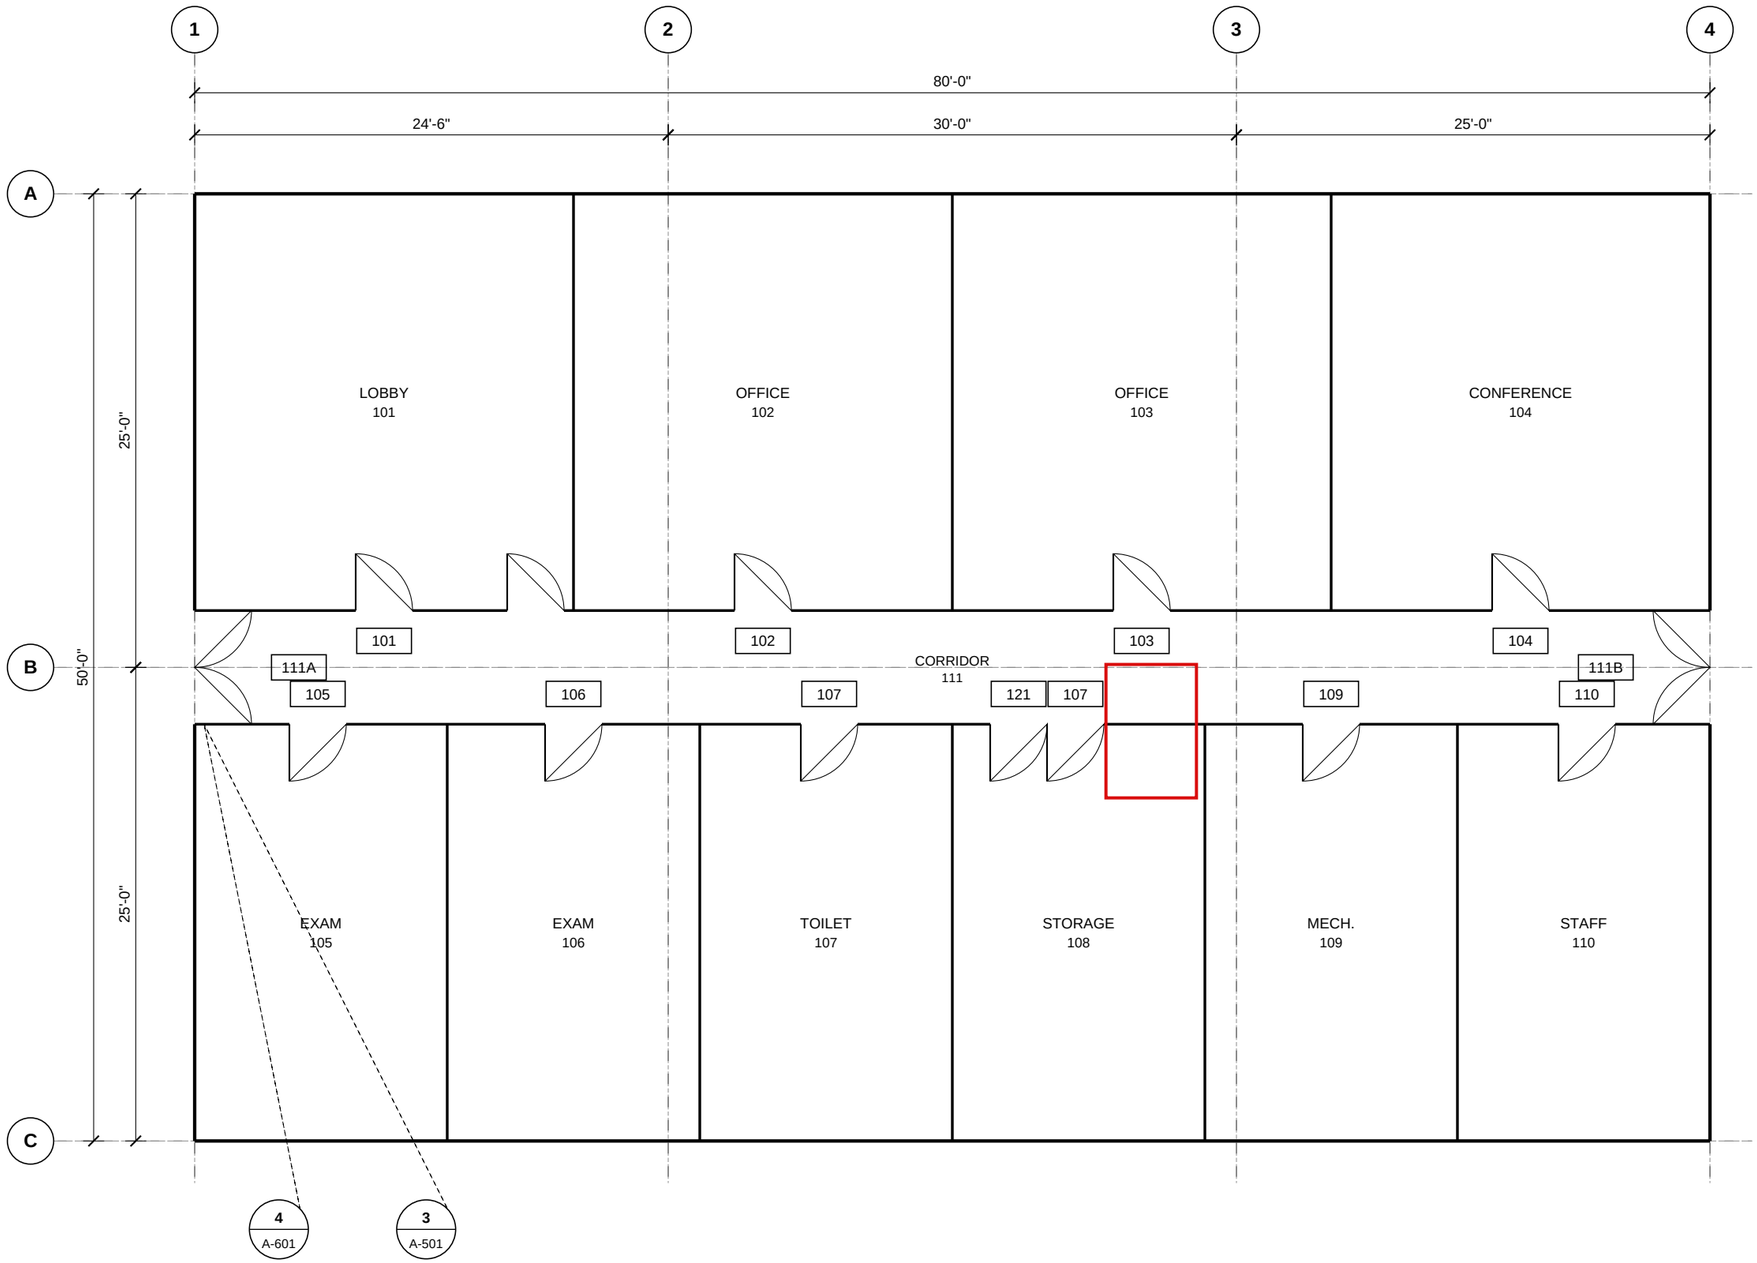

1 FIRST FLOOR PLAN SCALE: 1/8" = 1'-0"

NORTHWIND DESIGN STUDIO

SYNTHETIC SAMPLE - NOT FOR CONSTRUCTION

PROJECT:

RIVERSIDE COMMUNITY CLINIC

PROJECT NO.: 2026-014

REVISIONS

REV	DATE	DESCRIPTION
A	2026-08-14	ISSUED FOR BID

SHEET TITLE:

FIRST FLOOR PLAN

SCALE:

1/8" = 1'-0"

SHEET NO.


A-101

DOOR SCHEDULE


MARK	TYPE	WIDTH	HEIGHT	MATERIAL	FRAME	FIRE RATING	HDW SET	SPEC SECTION	REMARKS
101	D1	3'-0"	7'-0"	WD	HM	90 MIN	HW-1	08 14 16	
102	D1	3'-0"	7'-0"	WD	HM	20 MIN		08 14 16	
103	D1	3'-0"	7'-0"	WD	HM	-	HW-1	08 14 16	
104	D1	3'-0"	7'-0"	HM	HM	20 MIN	HW-1	08 14 16	
105	D1	3'-0"	7'-0"	WD	HM	-	HW-9	08 14 16	
106	D1	3'-0"	7'-0"	WD	HM	20 MIN	HW-1	08 14 16	
107	D2	3'-0"	7'-0"	HM	HM	-	HW-2	08 11 13	
108	D2	3'-0"	7'-0"	HM	HM	45 MIN	HW-2	08 11 13	
109	D2	3'-0"	7'-0"	HM	HM	60 MIN	HW-2	08 11 13	
110	D1	3'-0"	7'-0"	WD	HM	20 MIN	HW-1	08 14 16	
111A	D3	6'-0"	7'-0"	ALUM	ALUM	-	HW-4	08 41 13	
111B	D3	6'-0"	7'-0"	ALUM	ALUM	-	HW-4	08 41 13	
122	D1	3'-0"	7'-0"	WD	HM	-	HW-1	08 14 16	

F-02A


4 DOOR TYPES

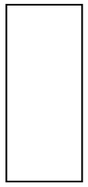

D1 - FLUSH WOOD, SOLID CORE
SEE SECTION 08 14 16

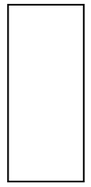

D2 - HOLLOW METAL, FLUSH
SEE SECTION 08 11 13

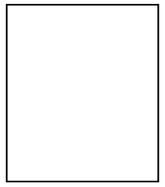

D3 - ALUM. STOREFRONT PAIR
SEE SECTION 08 41 13

NOTES:
1. HARDWARE SETS PER SECTION 08 71 00.
2. - IN FIRE RATING COLUMN = NON-RATED OPENING.

NORTHWIND DESIGN STUDIO
SYNTHETIC SAMPLE - NOT FOR CONSTRUCTION

PROJECT:
RIVERSIDE COMMUNITY CLINIC
PROJECT NO.: 2026-014

REVISIONS

REV	DATE	DESCRIPTION
A	2026-08-14	ISSUED FOR BID


SHEET TITLE:
DOOR SCHEDULE AND DOOR TYPES

SCALE:
AS NOTED

SHEET NO.
A-601

GENERAL NOTES:

1. RTU SUPPORT FRAMES ARE DESIGNED FOR THE MAX OPERATING WEIGHTS NOTED. COORDINATE WITH M-601.
2. DO NOT SCALE DRAWINGS.

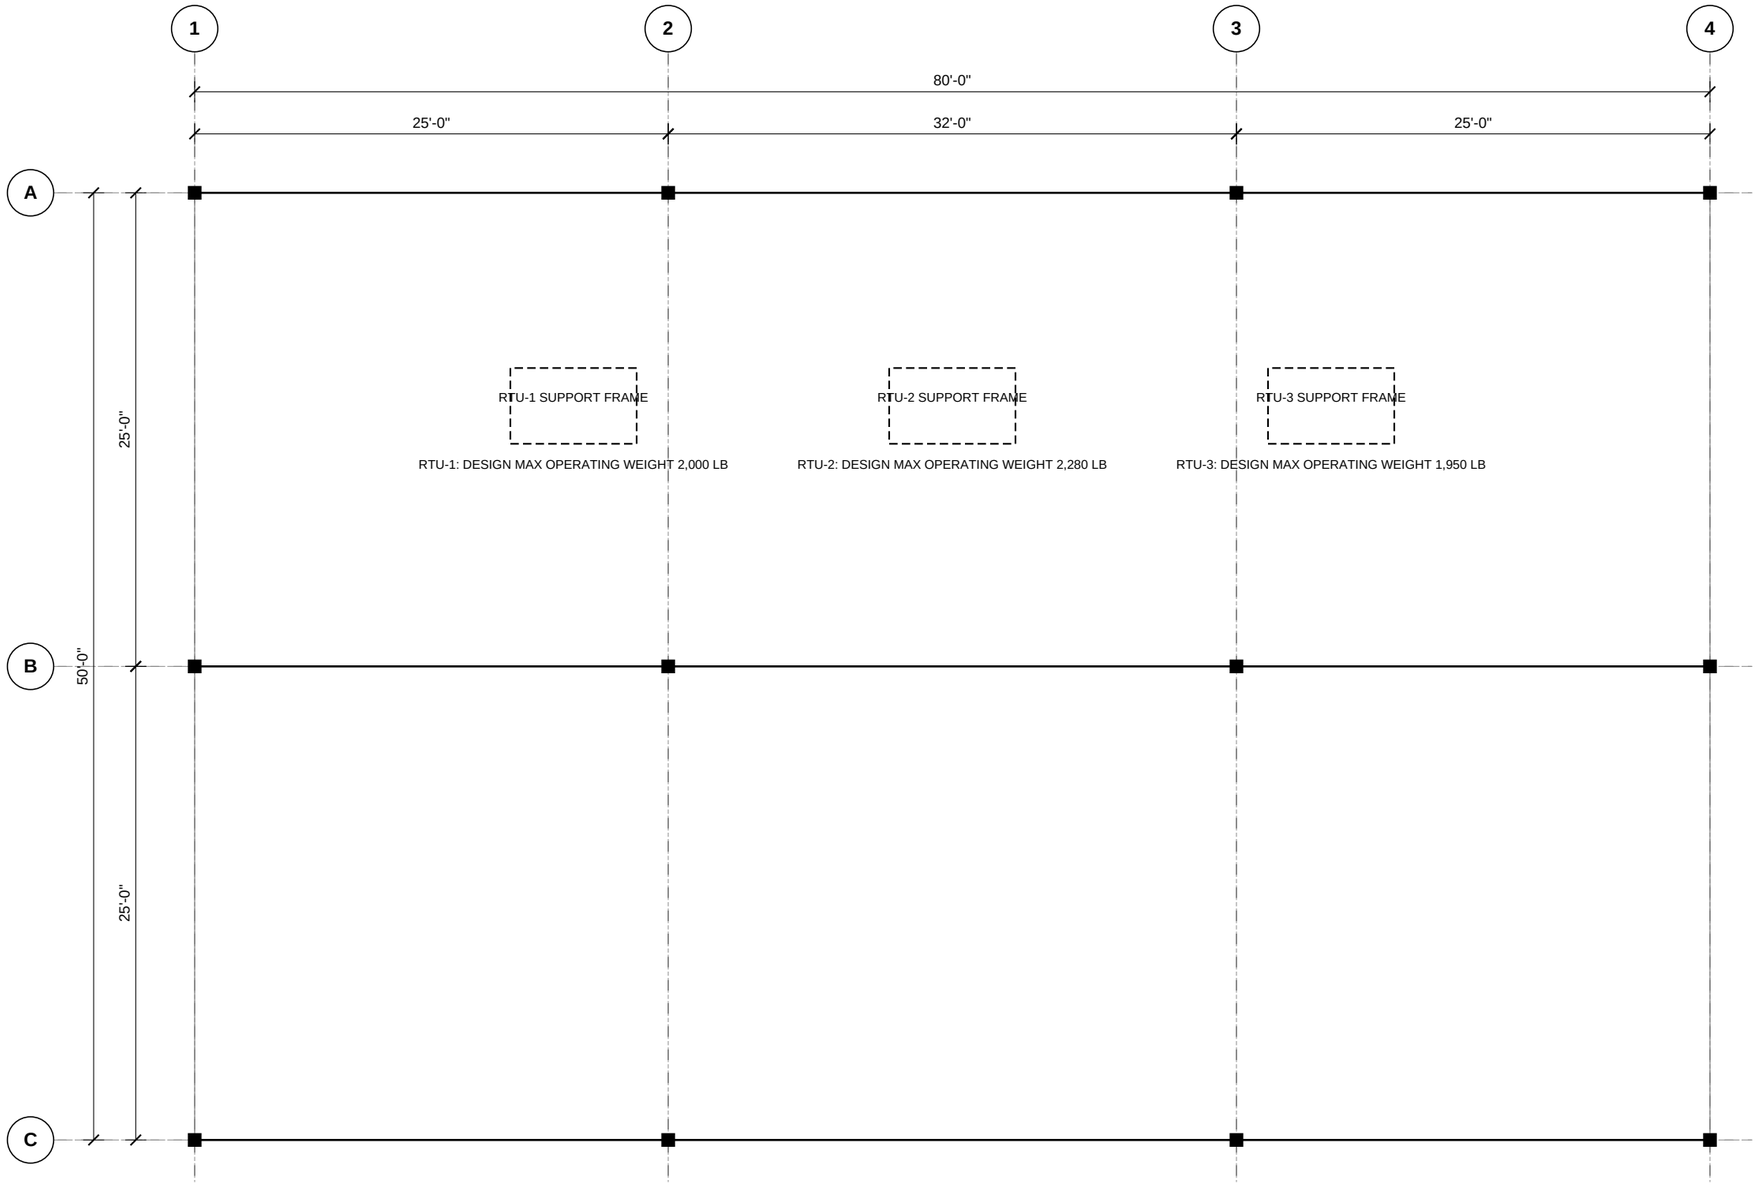

1 ROOF FRAMING PLAN SCALE: 1/8" = 1'-0"

NORTHWIND DESIGN STUDIO

SYNTHETIC SAMPLE - NOT FOR CONSTRUCTION

PROJECT:

RIVERSIDE COMMUNITY CLINIC

PROJECT NO.: 2026-014

REVISIONS

REV	DATE	DESCRIPTION
A	2026-08-14	ISSUED FOR BID

SHEET TITLE:

ROOF FRAMING PLAN

SCALE:


1/8" = 1'-0"

SHEET NO.

S-101

GENERAL NOTES:

1. RTUs ARE ROOF-MOUNTED ABOVE; SEE S-101 FOR SUPPORT FRAMING AND M-601 FOR SCHEDULE.
2. EQUIPMENT MARKED (NIC) IS FURNISHED AND INSTALLED BY OWNER.

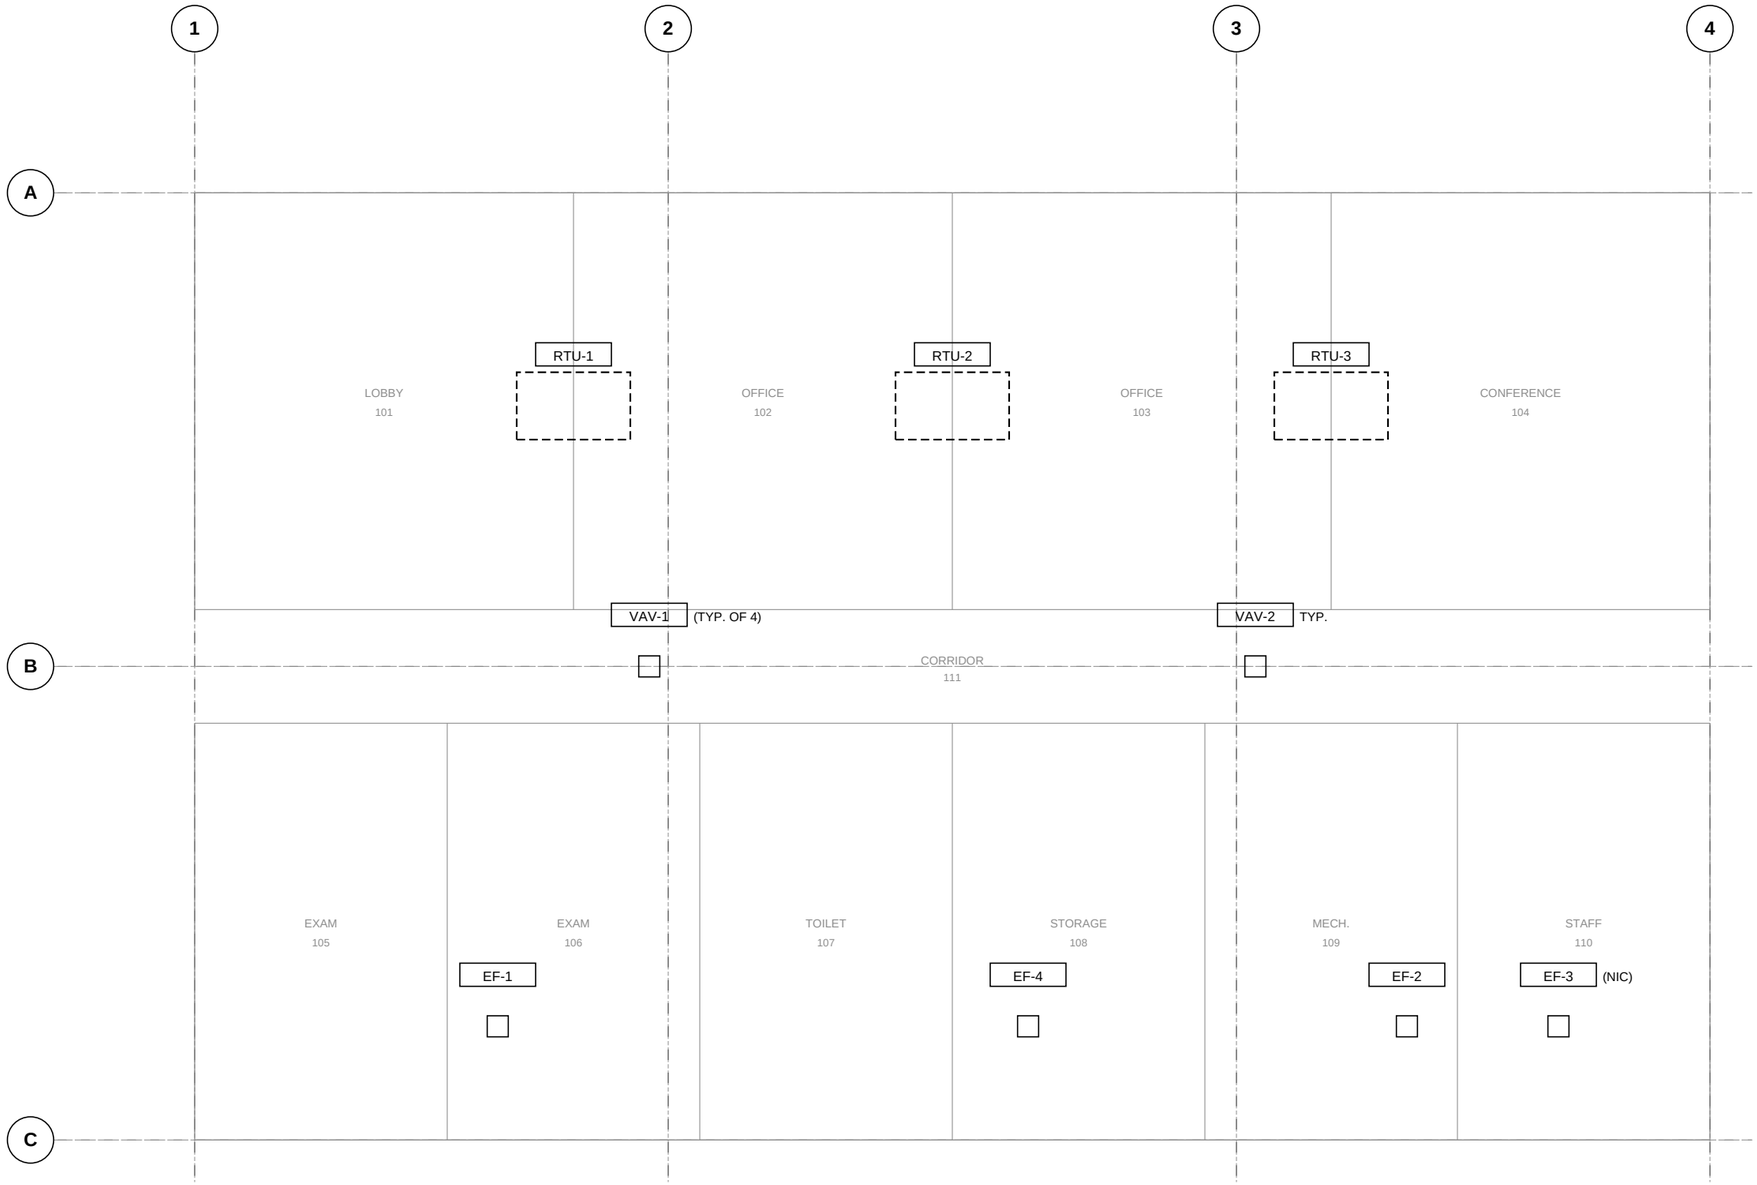

1 MECHANICAL FLOOR PLAN SCALE: 1/8" = 1'-0"

NORTHWIND DESIGN STUDIO

SYNTHETIC SAMPLE - NOT FOR CONSTRUCTION

PROJECT:

RIVERSIDE COMMUNITY CLINIC

PROJECT NO.: 2026-014

REVISIONS

REV	DATE	DESCRIPTION
A	2026-08-14	ISSUED FOR BID

SHEET TITLE:

MECHANICAL FLOOR PLAN

SCALE:

1/8" = 1'-0"

SHEET NO.

M-101

MECHANICAL EQUIPMENT SCHEDULE

TAG	DESCRIPTION	QTY	CAPACITY	V/PH	MCA (A)	WEIGHT (LB)	SPEC	REMARKS
RTU-1	ROOFTOP UNIT, GAS/ELEC	1	10 TON	460/3	45	2,450	23 74 13	R-410A, ECONOMIZER
RTU-2	ROOFTOP UNIT, GAS/ELEC	1	7.5 TON	460/3	35	1,980	23 74 13	R-454B, ECONOMIZER
RTU-3	ROOFTOP UNIT, GAS/ELEC	1	6 TON	460/3	30	1,650	23 74 13	R-454B, ECONOMIZER
EF-1	EXHAUST FAN, CEILING	1	300 CFM	120/1	-	45	23 34 16	
EF-2	EXHAUST FAN, CEILING	1	500 CFM	120/1	-	85	23 34 16	
EF-3	KITCHEN HOOD FAN	1	250 CFM	120/1	-	40	23 34 16	NIC - BY OWNER
VAV-1	VAV TERMINAL, 8 IN.	4	450 CFM	-	-	35	23 36 00	
VAV-2	VAV TERMINAL, 6 IN.	3	250 CFM	-	-	30	23 36 00	

NOTES:

1. ELECTRICAL CHARACTERISTICS SHALL BE COORDINATED WITH E-601 PRIOR TO ORDERING.
2. RTU OPERATING WEIGHTS SHALL NOT EXCEED STRUCTURAL DESIGN WEIGHTS ON S-101.

NORTHWIND DESIGN STUDIO

SYNTHETIC SAMPLE - NOT FOR CONSTRUCTION

PROJECT:

RIVERSIDE COMMUNITY CLINIC

PROJECT NO.: 2026-014

REVISIONS

REV	DATE	DESCRIPTION
A	2026-08-14	ISSUED FOR BID

SHEET TITLE:

MECHANICAL EQUIPMENT SCHEDULE

SCALE:

AS NOTED

SHEET NO.

M-601

PANEL HA: 480Y/277V, 3PH, 4W PANEL LA: 208Y/120V, 3PH, 4W

PANEL SCHEDULES (BRANCH CIRCUITS)

PANEL	CKT	LOAD	V/PH	POLES	BKR (A)
HA	1,3,5	RTU-1	460/3	3	55
HA	13,15,17	RTU-3	460/3	3	15
LA	3	EF-2	120/1	1	20
LA	5	EF-3	120/1	1	20
LA	7,9,11	RTU-2	208/3	3	45
LA	13	LIGHTING - CORRIDOR	120/1	1	20
LA	15	RECEPTACLES - OFFICES	120/1	1	20

NORTHWIND DESIGN STUDIO

SYNTHETIC SAMPLE - NOT FOR CONSTRUCTION

PROJECT:

RIVERSIDE COMMUNITY CLINIC

PROJECT NO.: 2026-014

REVISIONS

REV	DATE	DESCRIPTION
A	2026-08-14	ISSUED FOR BID

SHEET TITLE:

ELECTRICAL PANEL SCHEDULES

SCALE:

AS NOTED

SHEET NO.

E-601